


Apt. 3K aa pg. 104

INTERIOR OF UNITS ARE PRIVATE ELEMENTS
BALCONIES ARE LIMITED COMMON ELEMENTS

THE UNDERSIGNED, DAVID LINDSEY, A REGISTERED ARCHITECT IN THE STATE OF ALABAMA, HAS EXAMINED THE RECORD DRAWINGS FOR THE INTERIOR OF UNITS AND BALCONIES OF THE GRAND CARIBBEAN CONDOMINIUM, ORANGE BEACH, ALABAMA, AND HAS FOUND THAT THE SAME COMPLY WITH THE REQUIREMENTS OF THE ALABAMA CONDOMINIUM ACT, CHAPTER 40A, TITLE 40, ALABAMA CODE, AND THE DECLARATION OF CONDOMINIUM ATTACHED TO AND MADE PART OF THE RECORD DRAWINGS. THE UNDERSIGNED HAS NOT CONDUCTED A SURVEY OF THE PROPERTY AND DOES NOT GUARANTEE THE ACCURACY OF THE DIMENSIONS AND AREAS SHOWN ON THE RECORD DRAWINGS. THE UNDERSIGNED HAS NOT CONDUCTED A SURVEY OF THE PROPERTY AND DOES NOT GUARANTEE THE ACCURACY OF THE DIMENSIONS AND AREAS SHOWN ON THE RECORD DRAWINGS.

DAVID LINDSEY
ALABAMA REGISTRATION NUMBER 2417 DATE 7/16/85

UNIT	AREA - SQ. FT.
207	207
208	208
209	209
250	250

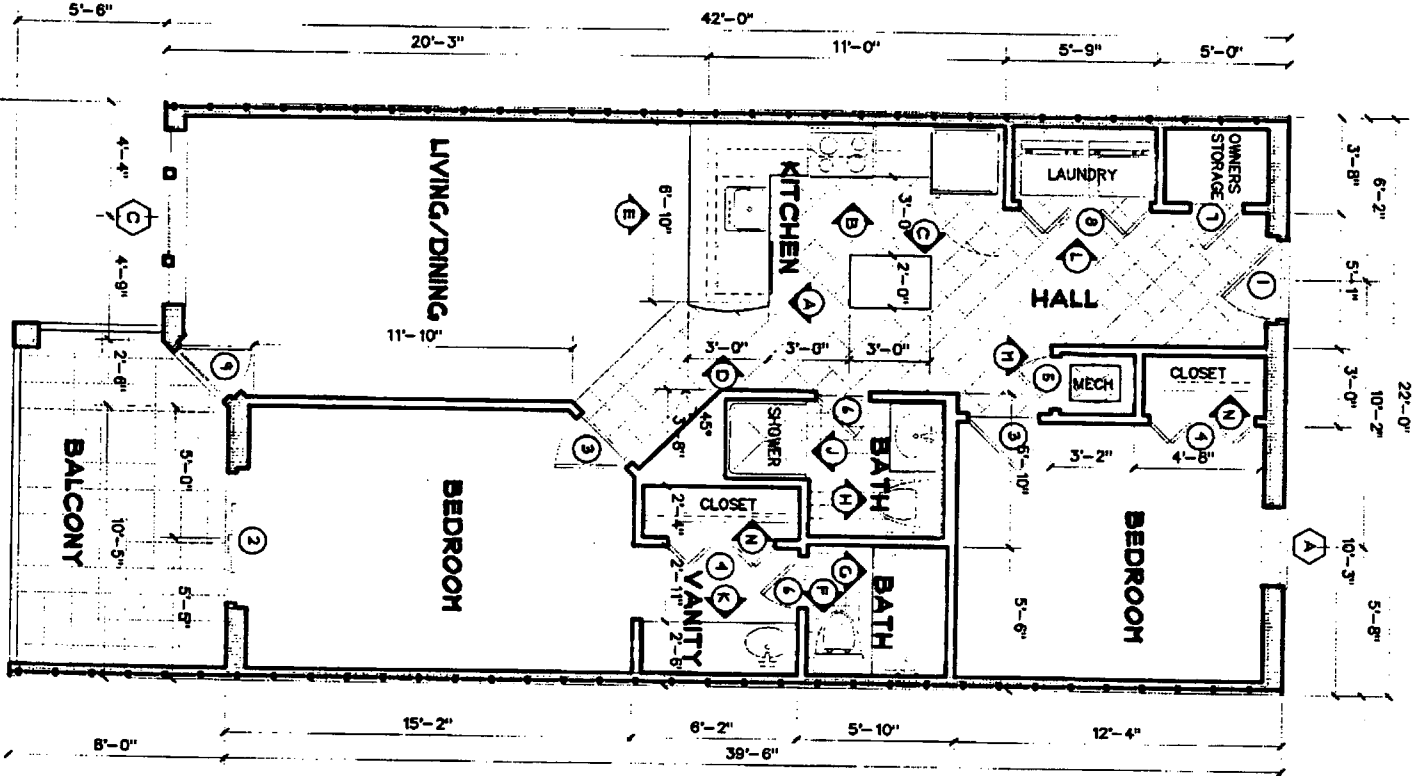

TWO BEDROOM UNIT
TYPE 'B'

LEGEND
1" = 1'-0" ICF WALL
1" = 1'-0" ICF WALL
1" = 1'-0" ICF WALL



13 OF SHEET NO.

A Multi-Family Development
The Grand Caribbean
Condominium
Orange Beach, Alabama

DAVID LINDSEY, ARCHITECT
DESIGN, PLANNING, INTERIORS

(251) 454-7213
104 RIVEROAKS DRIVE FAIRHOPE ALABAMA 36532

