


MS

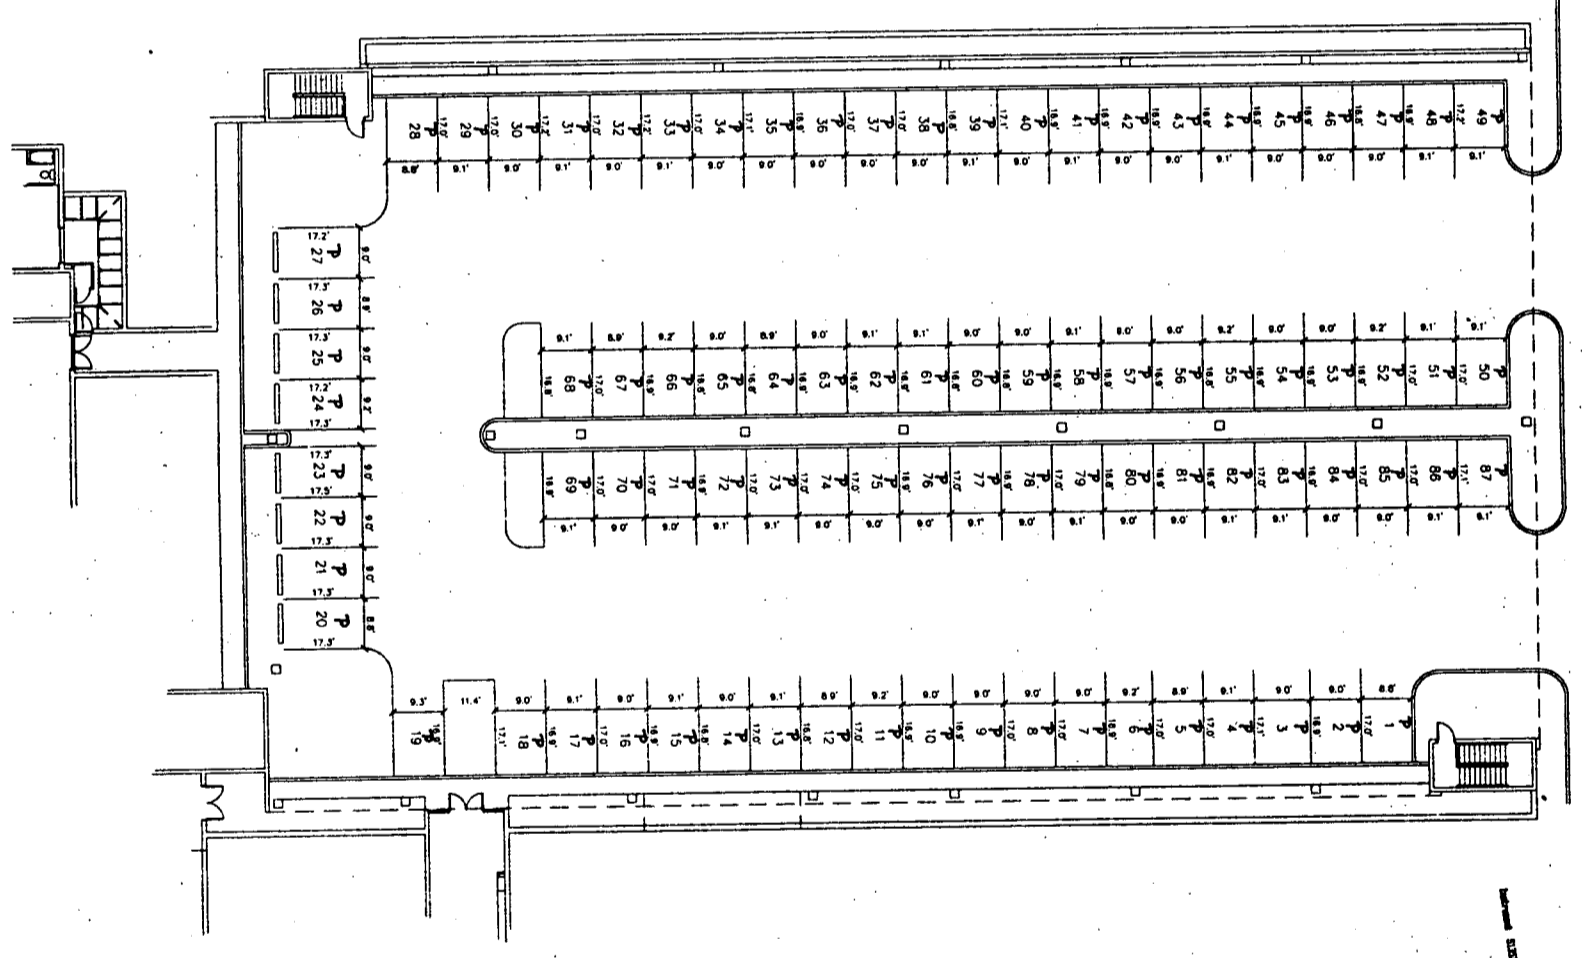

FLOOR ELEVATIONS VARY FROM ELEVATION 11.88 FEET TO ELEVATION 12.72 FEET

CEILING ELEVATIONS VARY FROM ELEVATION 20.32 FEET TO ELEVATION 21.58 FEET

GARAGE PLAN
N.T.S.

MAR SEPTEMBER, 1999

MIKELL D. SPEAKS & ASSOCIATES · CONSULTING ENGINEERS, INCORPORATED

732 OAK CIRCLE DRIVE WEST · MOBILE, ALABAMA

99-911 908 NBT 10 SCALE

ALABAMA BUSINESS RECORDS CORPORATION

I, MIKELL D. SPEAKS, A REGISTERED LAND SURVEYOR IN THE STATE OF ALABAMA, HEREBY CERTIFY THAT THE FOLLOWING DIMENSIONS FOR THE UNITS IN PHOENIX VII CONDOMINIUMS ARE TRUE AND CORRECT.

Mikell D. Speaks
ALABAMA REGISTRATION NO. 9127
SEPTEMBER 20, 1999

AS BUILT SURVEY
PHOENIX VII
BALDWIN COUNTY, ALABAMA

BY GIS 019 OR 150