


NBS

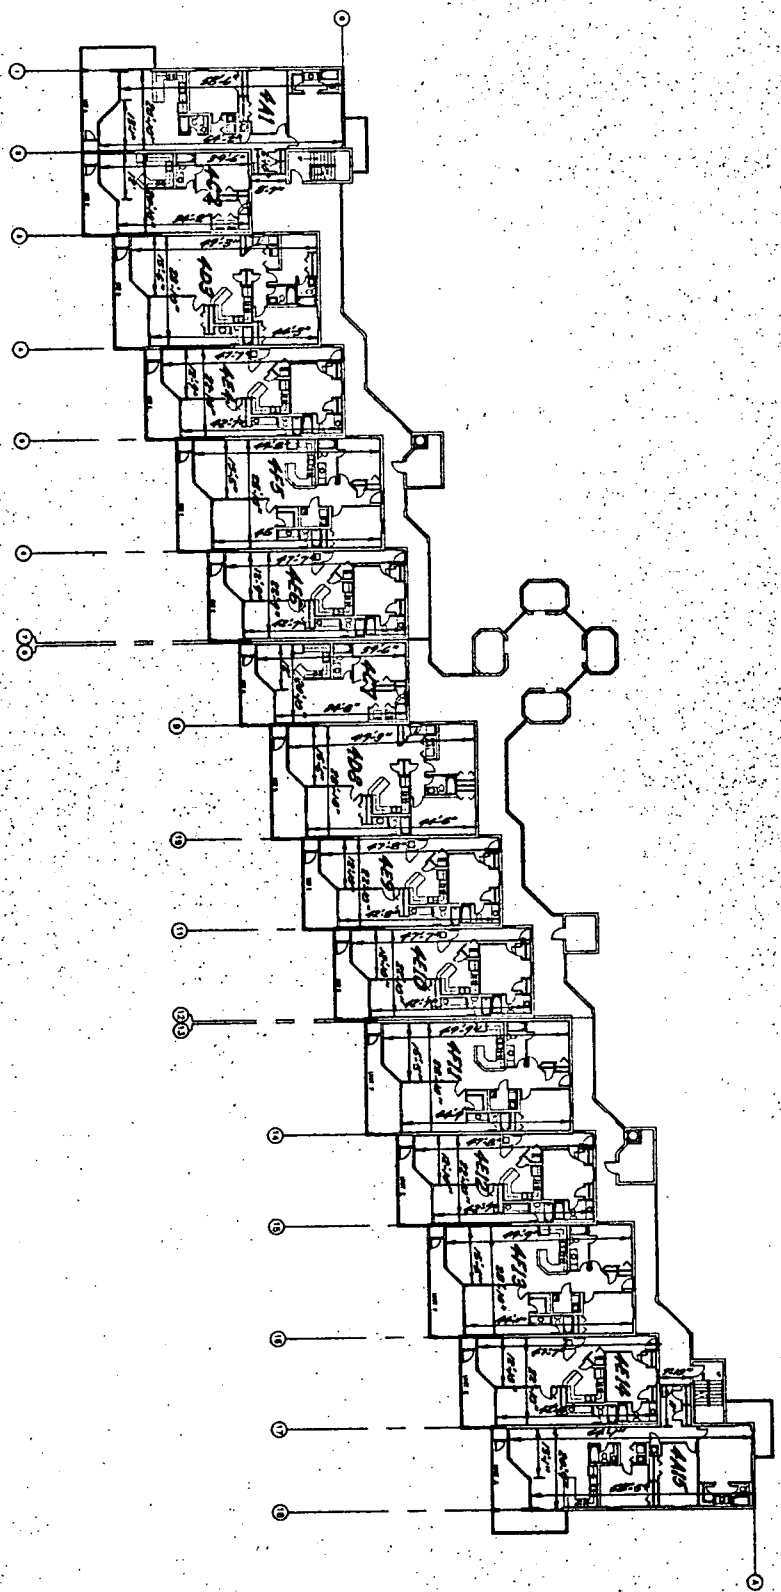

FOURTH FLOOR PLAN



I, MIKELL D. SPEAKS, A REGISTERED LAND SURVEYOR IN THE STATE OF ALABAMA, HEREBY CERTIFY THAT THE FOLLOWING DIMENSIONS FOR THE UNITS IN PHOENIX VII CONDOMINIUMS ARE TRUE AND CORRECT.
Mikell D. Speaks
ALABAMA REGISTRATION NO. 9127
SEPTEMBER 20, 1999

MIKELL D. SPEAKS & ASSOCIATES • CONSULTING ENGINEERS, INCORPORATED
732 OAK CIRCLE DRIVE WEST • MOBILE, ALABAMA

PHOENIX VII
"AS BUILT"

REV 019 MAR 145