


App. BK 22 pg 52

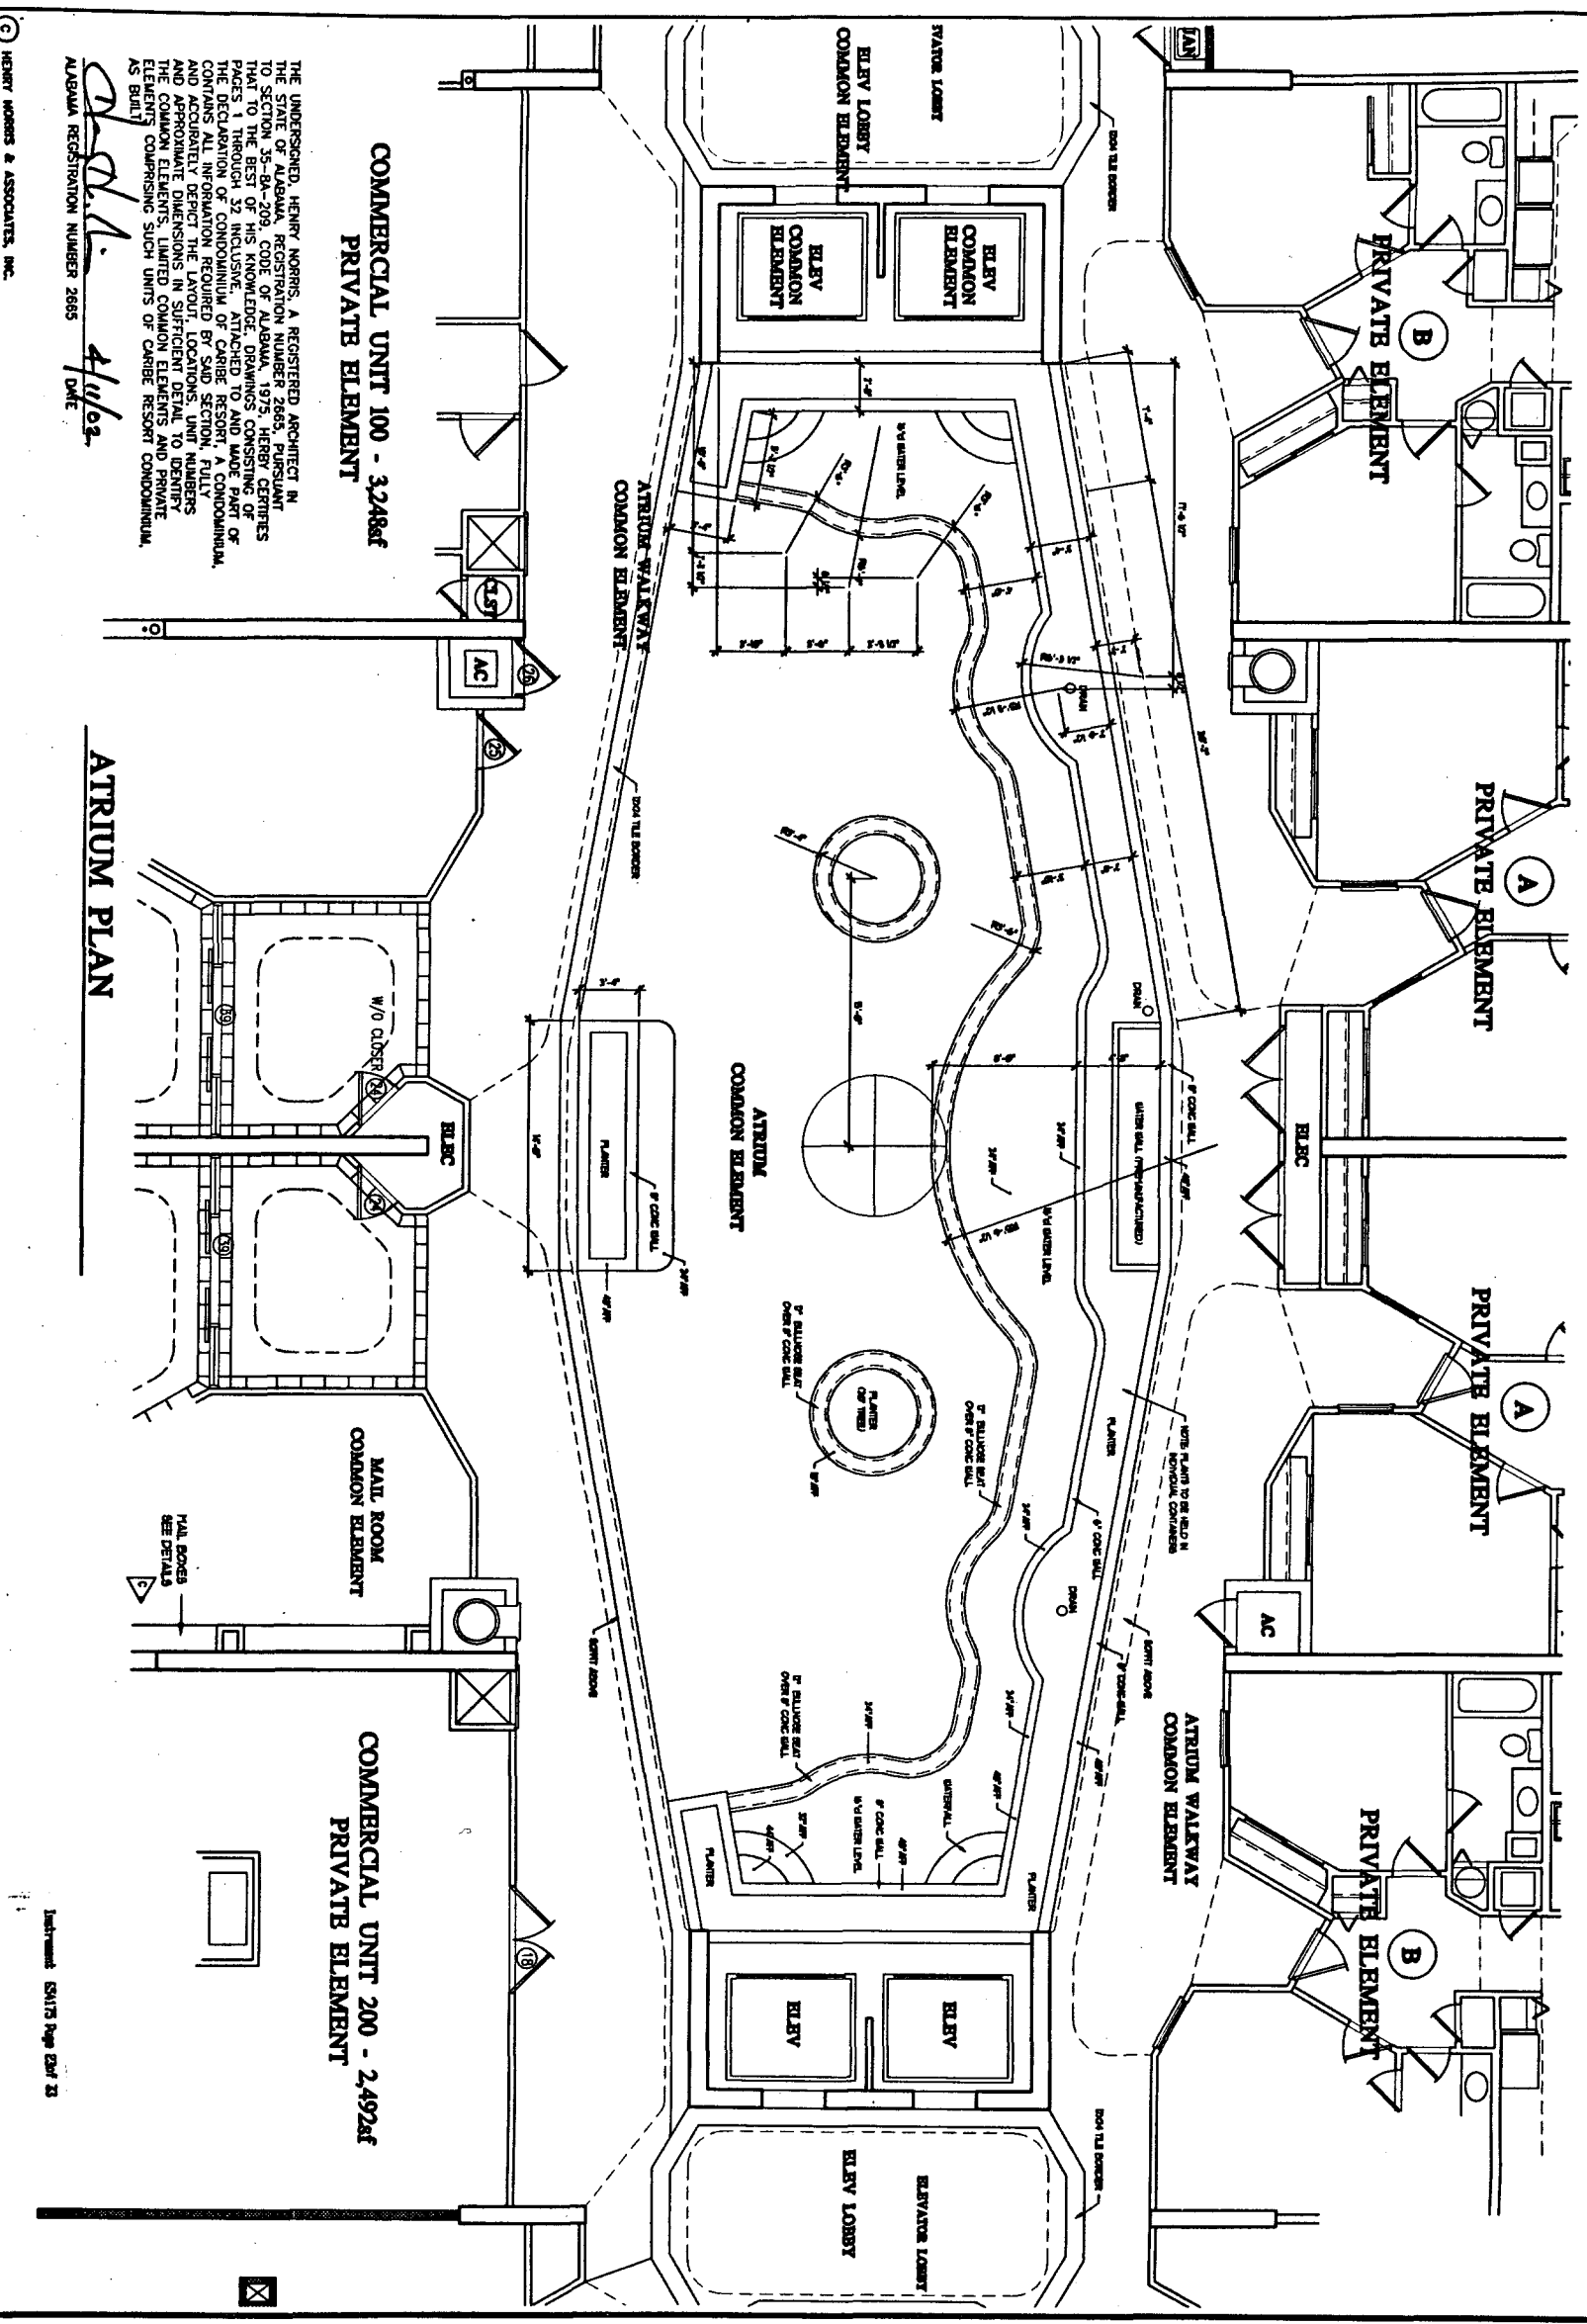

**COMMERCIAL UNIT 100 - 3248sf**  
**PRIVATE ELEMENT**

**COMMERCIAL UNIT 200 - 2492sf**  
**PRIVATE ELEMENT**

THE UNDERSIGNED, HENRY NORRIS, A REGISTERED ARCHITECT IN THE STATE OF ALABAMA, REGISTRATION NUMBER 2865, PURSUANT TO SECTION 35-8A-209, CODE OF ALABAMA, 1975, HEREBY CERTIFIES THAT TO THE BEST OF HIS KNOWLEDGE, DRAWINGS CONSISTING OF THESE DRAWINGS, INCLUDING THE SPECIFICATIONS ATTACHED TO AND MADE PART OF THE DECLARATION OF CONVEYANCE, ATTACHED TO AND MADE PART OF THE DECLARATION OF CONVEYANCE, ATTACHED TO AND MADE PART OF AND ACCURATELY DEPICT THE LAYOUT, LOCATIONS, UNIT NUMBERS AND APPROXIMATE DIMENSIONS IN SUFFICIENT DETAIL TO IDENTIFY ELEMENTS COMPRISING SUCH UNITS OF CARIBE RESORT CONDOMINIUM, AS BUILT.

*H. Norris*  
 HENRY NORRIS  
 ALABAMA REGISTRATION NUMBER 2865  
 DATE 4/1/02

**ATRIUM PLAN**

© HENRY NORRIS & ASSOCIATES, INC.

REGISTERED ARCHITECTS  
 HENRY NORRIS & ASSOCIATES, INC.  
 1000 W. UNIVERSITY BLVD., SUITE 200  
 TALLAHASSEE, FLORIDA 32303-2000  
 TEL: 904-224-1111  
 FAX: 904-224-1112

Scale: 1/8" = 1'-0"  
 SHEET: SK173 Page 25 of 25

	HENRY NORRIS & ASSOCIATES, INC. ARCHITECTURE & ENVIRONMENTAL DESIGN
	20 N. PALMER BOULEVARD, SUITE 200 TALLAHASSEE, FLORIDA 32303 TEL: 904-224-1111 FAX: 904-224-1112
<b>CARIBE RESORT</b> ORANGE BEACH, ALABAMA	
JOB NO.: 0908007 DATE: 10-01-01 CHECKED: HAN DATE: 4-1-02 DESIGNED: HAN DATE: 4-1-02	FLOOR PLAN - ATRIUM SHEET <b>22</b> OF 25