


Apr 22 pg 41

NOTE:  
ALL RESIDENTIAL UNIT BALCONIES ARE TO BE LIMITED COMMON ELEMENT.  
ALL RESIDENTIAL UNITS ARE TO BE PRIVATE ELEMENT.  
ALL OTHER AREAS TO BE COMMON ELEMENTS UNLESS OTHERWISE NOTED.

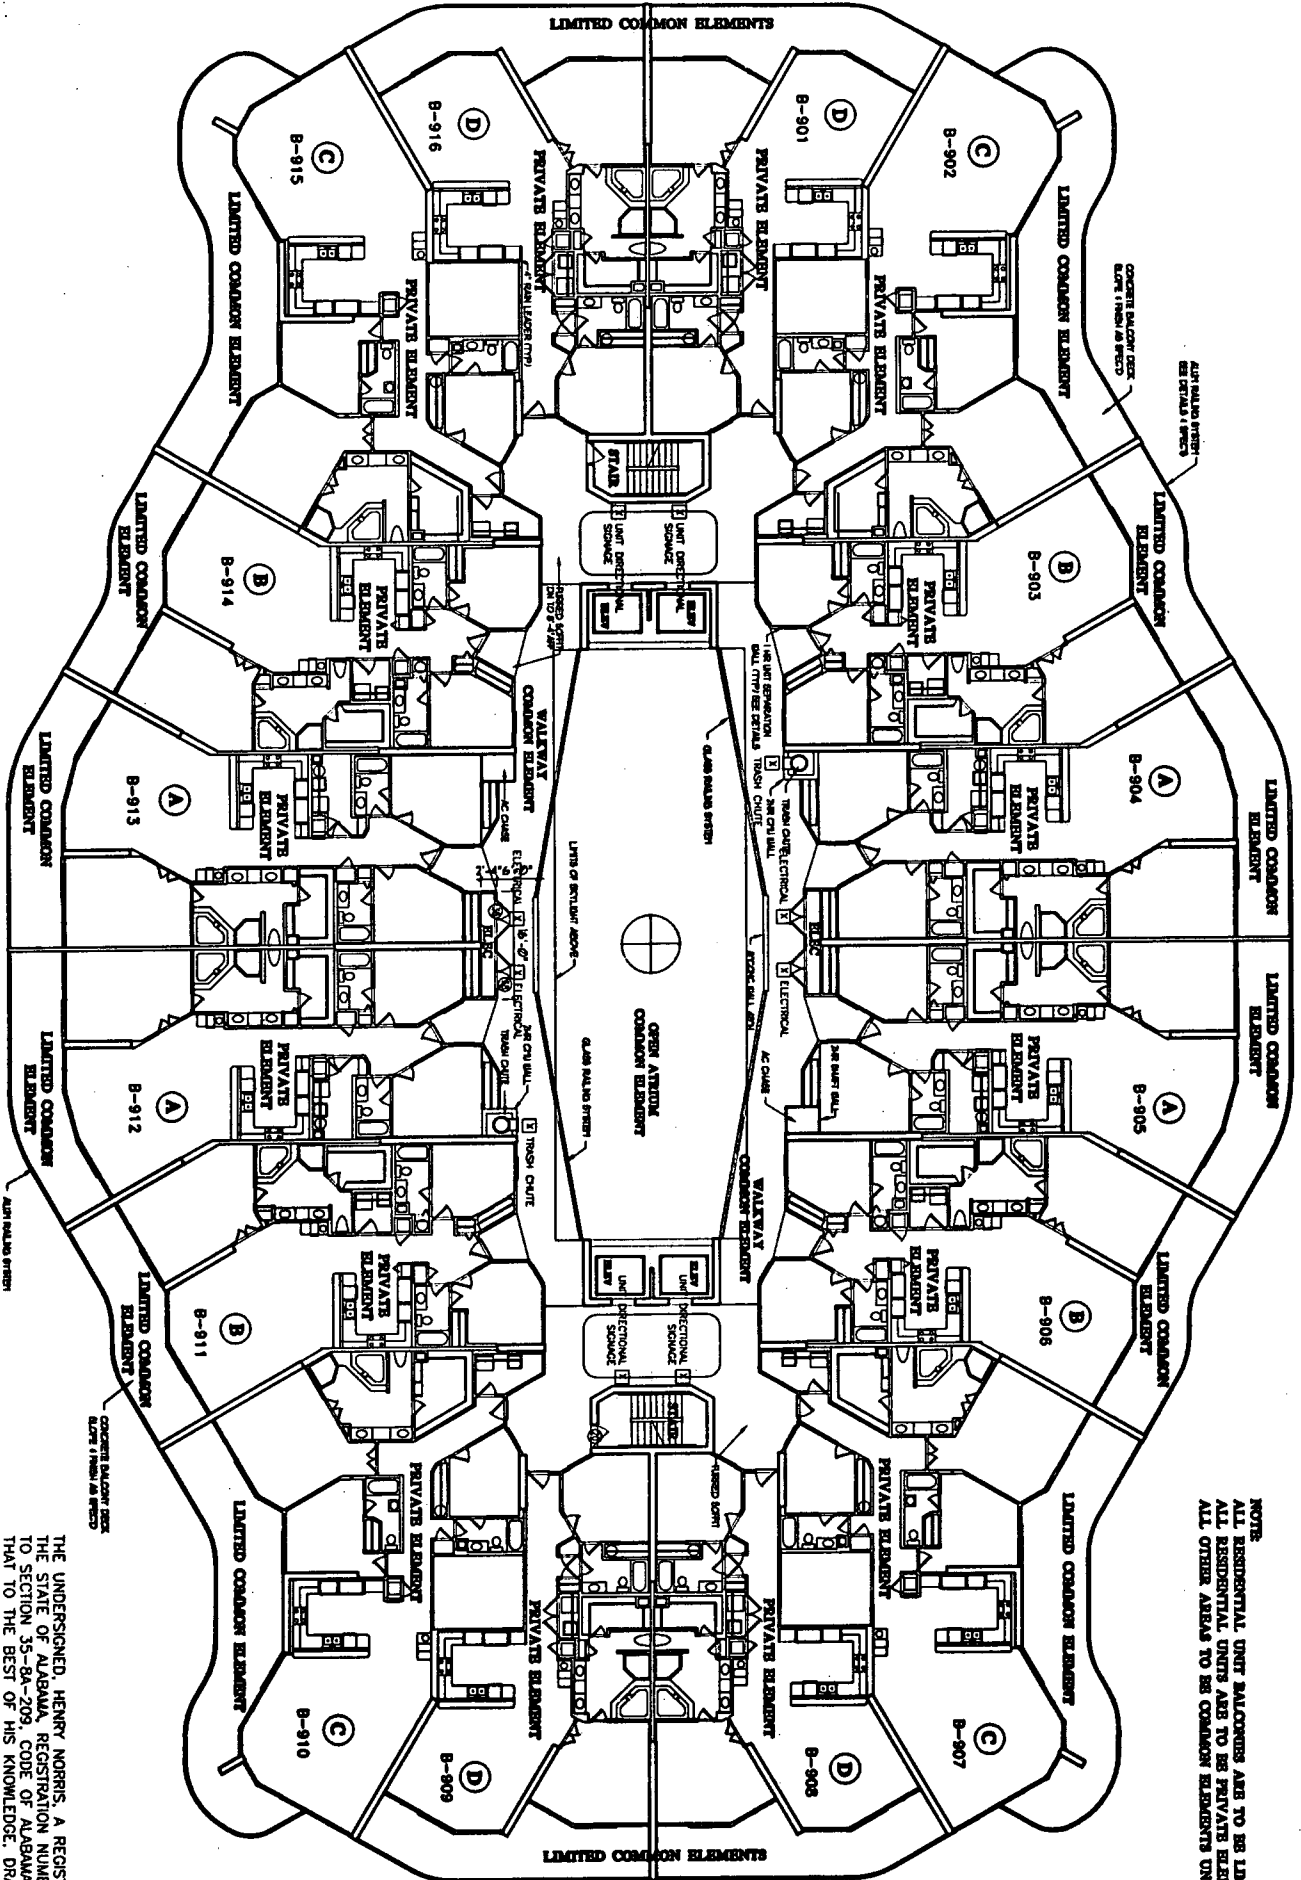

TYPICAL FLOOR PLAN LEVEL 10

THE UNDERSIGNED, HENRY NORRIS, A REGISTERED ARCHITECT IN THE STATE OF ALABAMA, REGISTRATION NUMBER 2665, PURSUANT TO SECTION 35-8A-209, CODE OF ALABAMA, 1975, HERBY CERTIFIES THAT TO THE BEST OF HIS KNOWLEDGE, DRAWINGS CONSISTING OF PAGES 1 THROUGH 32 INCLUSIVE, ATTACHED TO AND MADE PART OF THE DECLARATION OF CONDOMINIUM OF CARIBE RESORT, A FULLY CONTAINS ALL INFORMATION REQUIRED BY SAID SECTION, FULLY AND ACCURATELY DEPICT THE LAYOUT, LOCATIONS, UNIT NUMBERS AND APPROXIMATE DIMENSIONS IN SUFFICIENT DETAIL TO IDENTIFY THE COMMON ELEMENTS, LIMITED COMMON ELEMENTS AND PRIVATE ELEMENTS COMPRISING SUCH UNITS OF CARIBE RESORT CONDOMINIUM, AS BUILT.

*Henry Norris*  
ALABAMA REGISTRATION NUMBER 2665  
DATE: *4/16/02*

Sheet: GA12 Page 12 of 23



HENRY NORRIS & ASSOC., INC.  
ARCHITECTURE & ENVIRONMENTAL DESIGN

30 N. PALMYRA  
PENSACOLA,  
FLORIDA 32501  
(904) 432-2011  
FAX 432-2011  
henry@hennorris.com

CARIBE RESORT  
ORANGE BEACH, ALABAMA

AS BUILT  
DATE: 4/16/02

TYP FLOOR PLAN  
SHEET  
11  
OF 23

