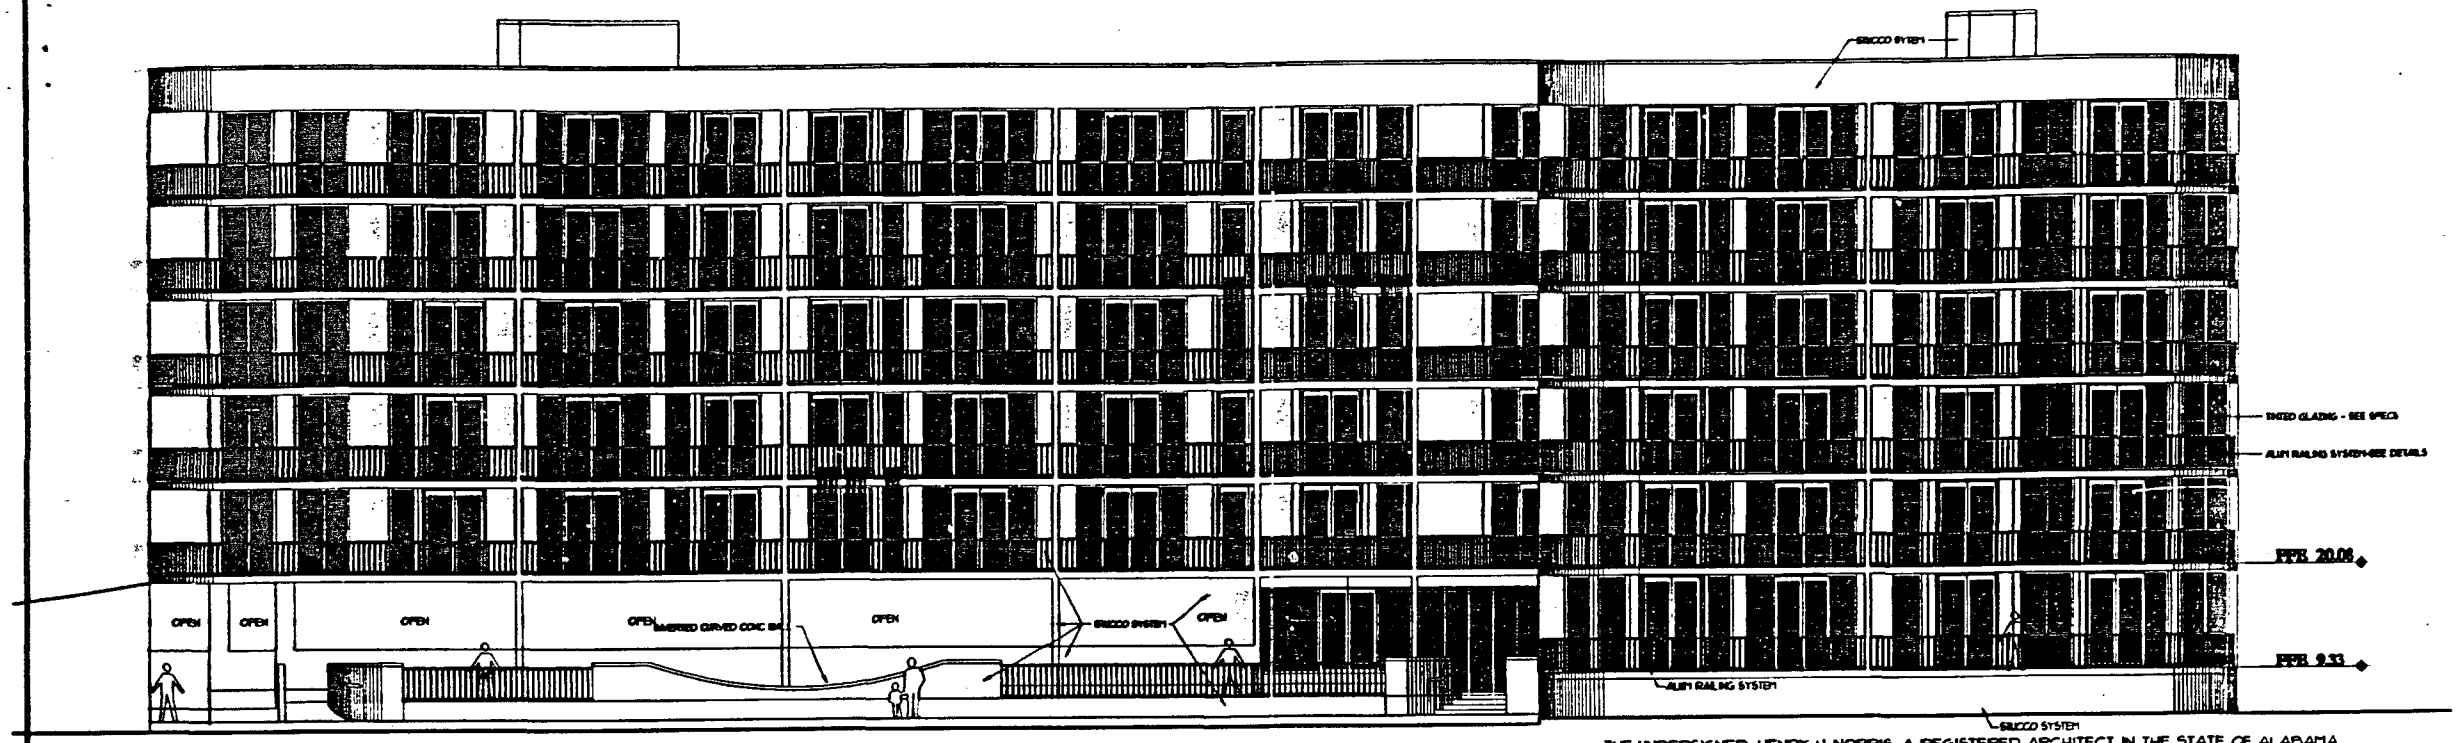

NORTH (REAR) ELEVATION

1/8"=1'-0"

THE UNDERSIGNED, HENRY H. NORRIS, A REGISTERED ARCHITECT IN THE STATE OF ALABAMA, REGISTRATION NUMBER 2665, PURSUANT TO SECTION 35-8A-209, CODE OF ALABAMA, 1975, HEREBY CERTIFIES THAT TO THE BEST OF HIS KNOWLEDGE DRAWINGS, CONSISTING OF PAGES 1 THROUGH 19 INCLUSIVE, ATTACHED TO AND MADE PART OF THE DECLARATION OF CONDOMINIUM OF THE PASS, A CONDOMINIUM, CONTAINS ALL INFORMATION REQUIRED BY SAID SECTION, FULLY AND ACCURATELY DEPICTS THE LAYOUT, LOCATIONS, UNIT NUMBERS AND APPROXIMATE DIMENSIONS IN SUFFICIENT DETAIL TO IDENTIFY THE COMMON ELEMENTS, LIMITED COMMON ELEMENTS AND PRIVATE ELEMENTS COMPRISING SUCH UNITS OF THE PASS, A CONDOMINIUM, AS BUILT.

ALABAMA REGISTRATION NUMBER 2665 — DATE 8/22/02

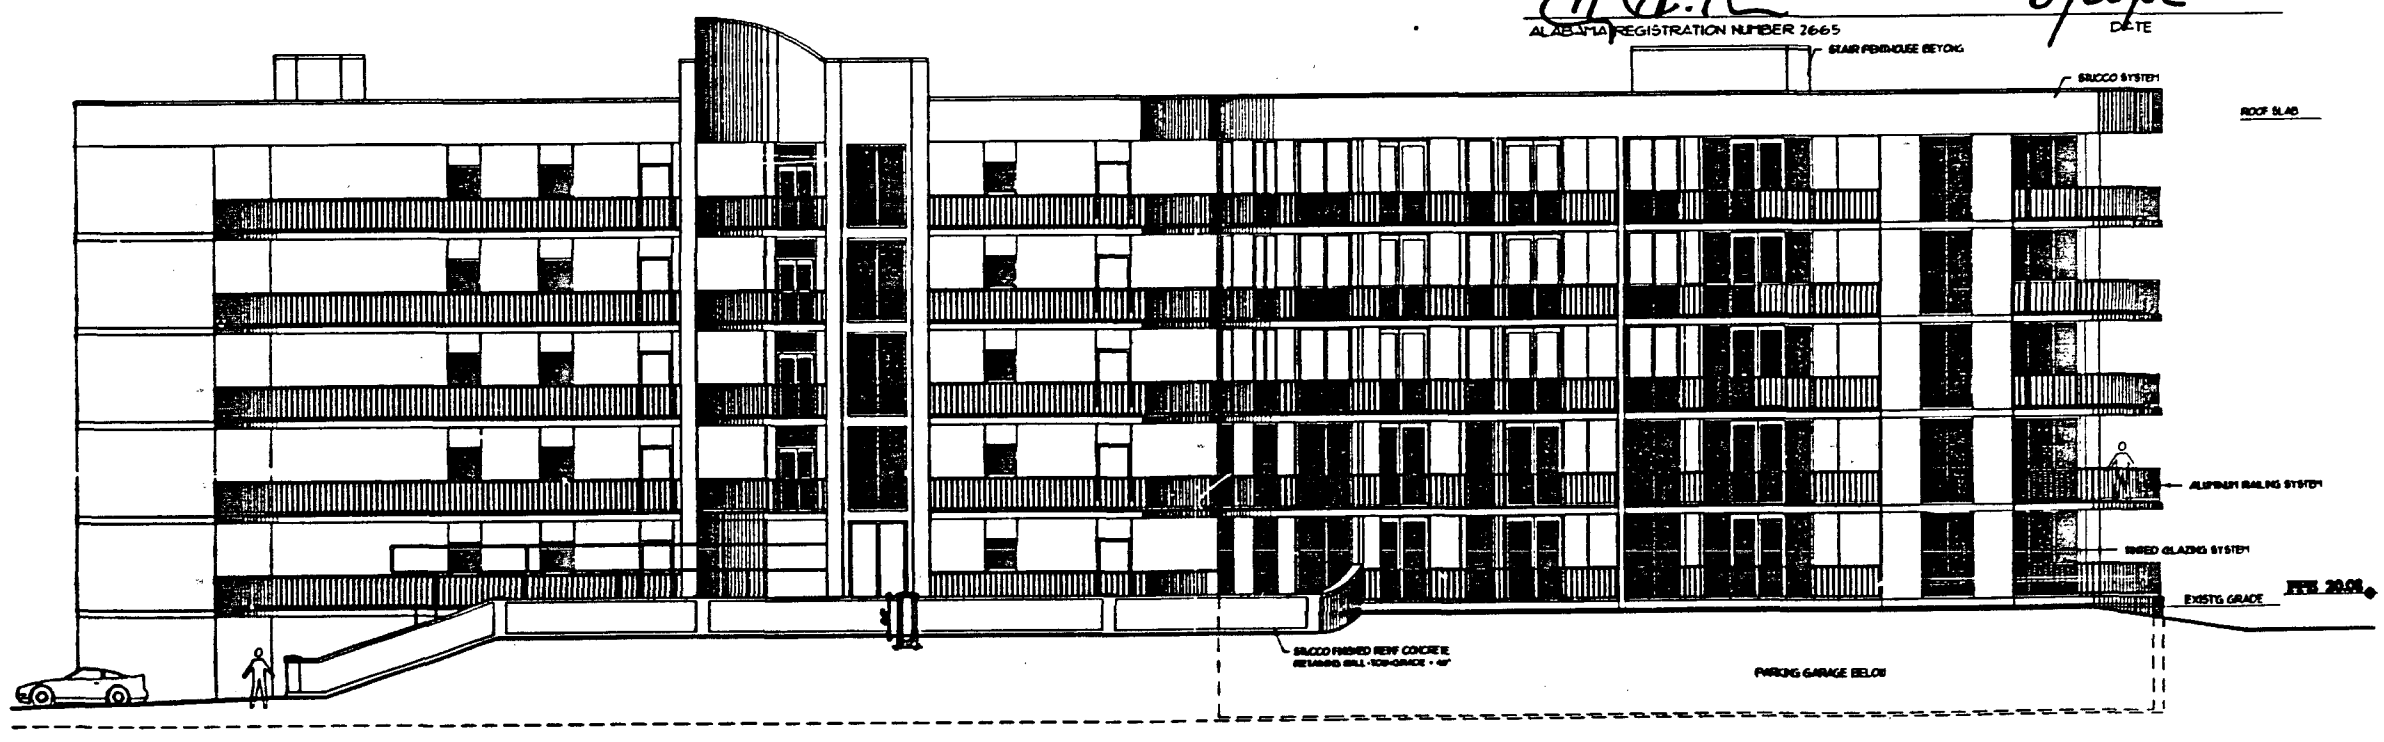

SOUTH (FRONT) ELEVATION

1/8"=1'-0"

Instrument 678028 Page 9of 20

Apt Bk 22 pg 82

© HENRY NORRIS & ASSOCIATES, INC.

IF SHEET IS NOT 24"X36" THEN REDUCE SCALE BY HALF.

HENRY NORRIS & ASSOC., INC.
ARCHITECTURE & ENVIRONMENTAL DESIGN
30 N. PALAFOX
PENSACOLA, FLORIDA 32514
(850) 432-6011
FAX 435-9001
www.hnorris.com

THE PASS
A CONDOMINIUM RESORT

JOB NO.: [illegible]
CKD: MGAL
CHECKED: HHN
DATE: [illegible]
REVISIONS:

Elevations

SHEET 8 OF 19

BUSINESS RECORDS CORPORATION