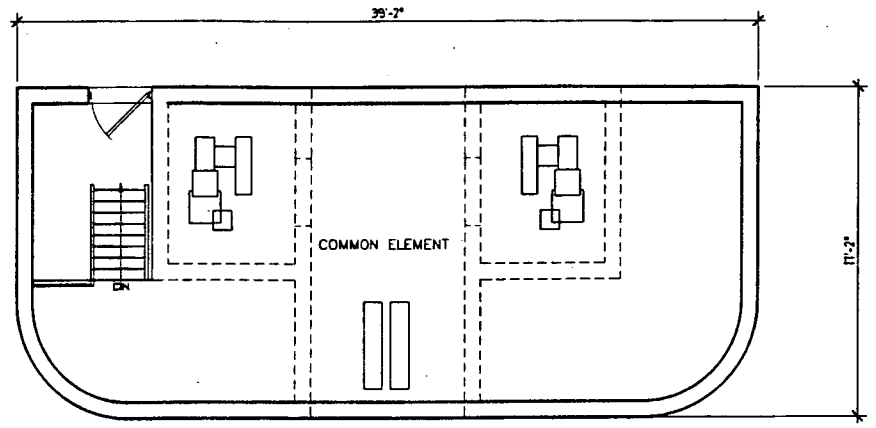

ENLARGED ELEV EQUIP ROOM
1/4"=1'-0"

THE UNDERSIGNED, HENRY NORRIS, A REGISTERED ARCHITECT IN THE STATE OF ALABAMA, REGISTRATION NUMBER 2665, PURSUANT TO SECTION 35-8A-209, CODE OF ALABAMA, 1975, HERBY CERTIFIES THAT TO THE BEST OF HIS KNOWLEDGE, DRAWINGS CONSISTING OF PAGES 1 THROUGH 11 INCLUSIVE, ATTACHED TO AND MADE PART OF THE DECLARATION OF CONDOMINIUM OF TIDEWATER, A CONDOMINIUM, CONTAINS ALL INFORMATION REQUIRED BY SAID SECTION, FULLY AND ACCURATELY DEPICT THE LAYOUT, LOCATIONS, UNIT NUMBERS AND APPROXIMATE DIMENSIONS IN SUFFICIENT DETAIL TO IDENTIFY THE COMMON ELEMENTS, LIMITED COMMON ELEMENTS AND PRIVATE ELEMENTS COMPRISING SUCH UNITS OF TIDEWATER CONDOMINIUM, AS BUILT.

11/5/99

ALABAMA REGISTRATION NUMBER 2665 DATE

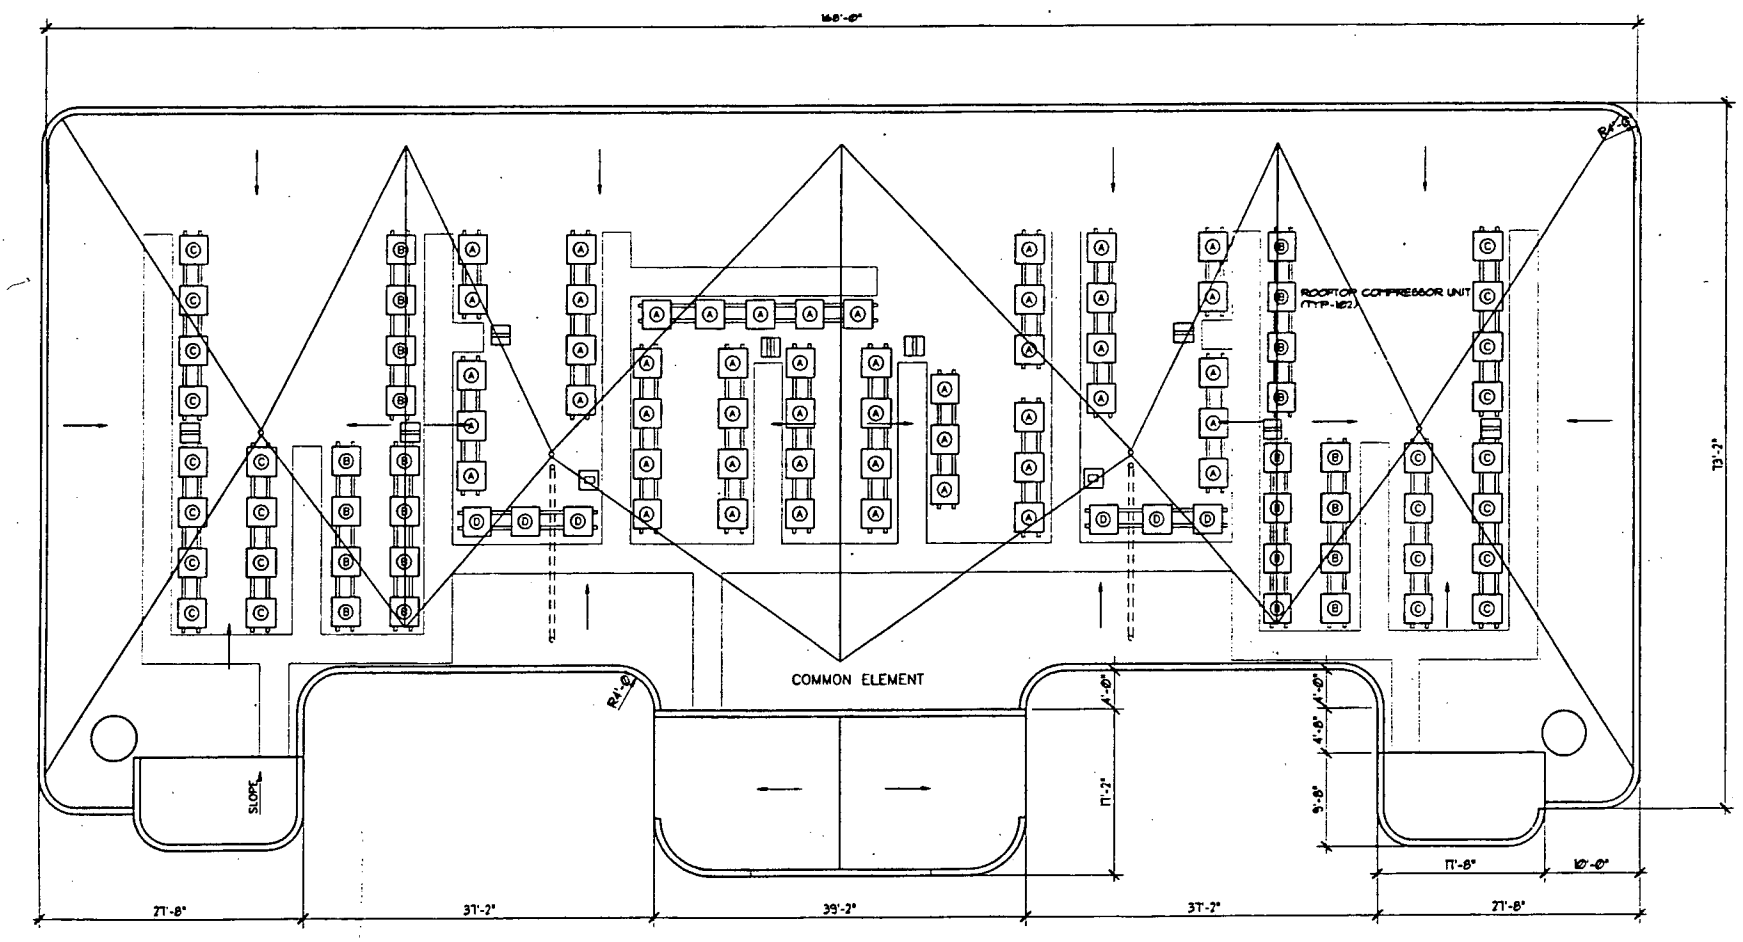

ROOF PLAN
1/8"=1'-0"

44030.002

© HENRY NORRIS & ASSOCIATES, INC.

HN
HENRY NORRIS & ASSOC., INC.
ARCHITECTURE & ENVIRONMENTAL DESIGN
30 N. PALAFOX
PENSACOLA, FLORIDA 32501
(904) 432-6011
FAX 435-9001

TIDEWATER
CONDOMINIUMS
ORANGE BEACH, ALABAMA

JOB NO.: 099711
CAD: MGIL
CHECKED: HN
DATE: 11/3/99
REVISION:

SHEET 5 OF

BUSINESS RECORDS CORPORATION